

6550 101, 102, 201, 202

6556 101, 102, 201, 202

6552 101, 102, 201, 202

OUTER

INNER

Irrigation As-Built  
By: The Water Works  
New Cortez Pk W.  
Bradenton, FL 34105


Legend

- ▲ - 2" zone valve
- - Point of connection
- - Push shut-off device
- - Irrigation controller
- ⊙ - Gate valve
- 3" Mainline

Footnotes...

- ① Water connection is in Lake Wood Ranch median
- ② Water connection is Lake Wood Ranch Lake on Holland Lane
- ③ Median runs with Building #7
- ④ 2" main line to Island runs under deck - shown in water for clarity

136 units  
34 Bldgs

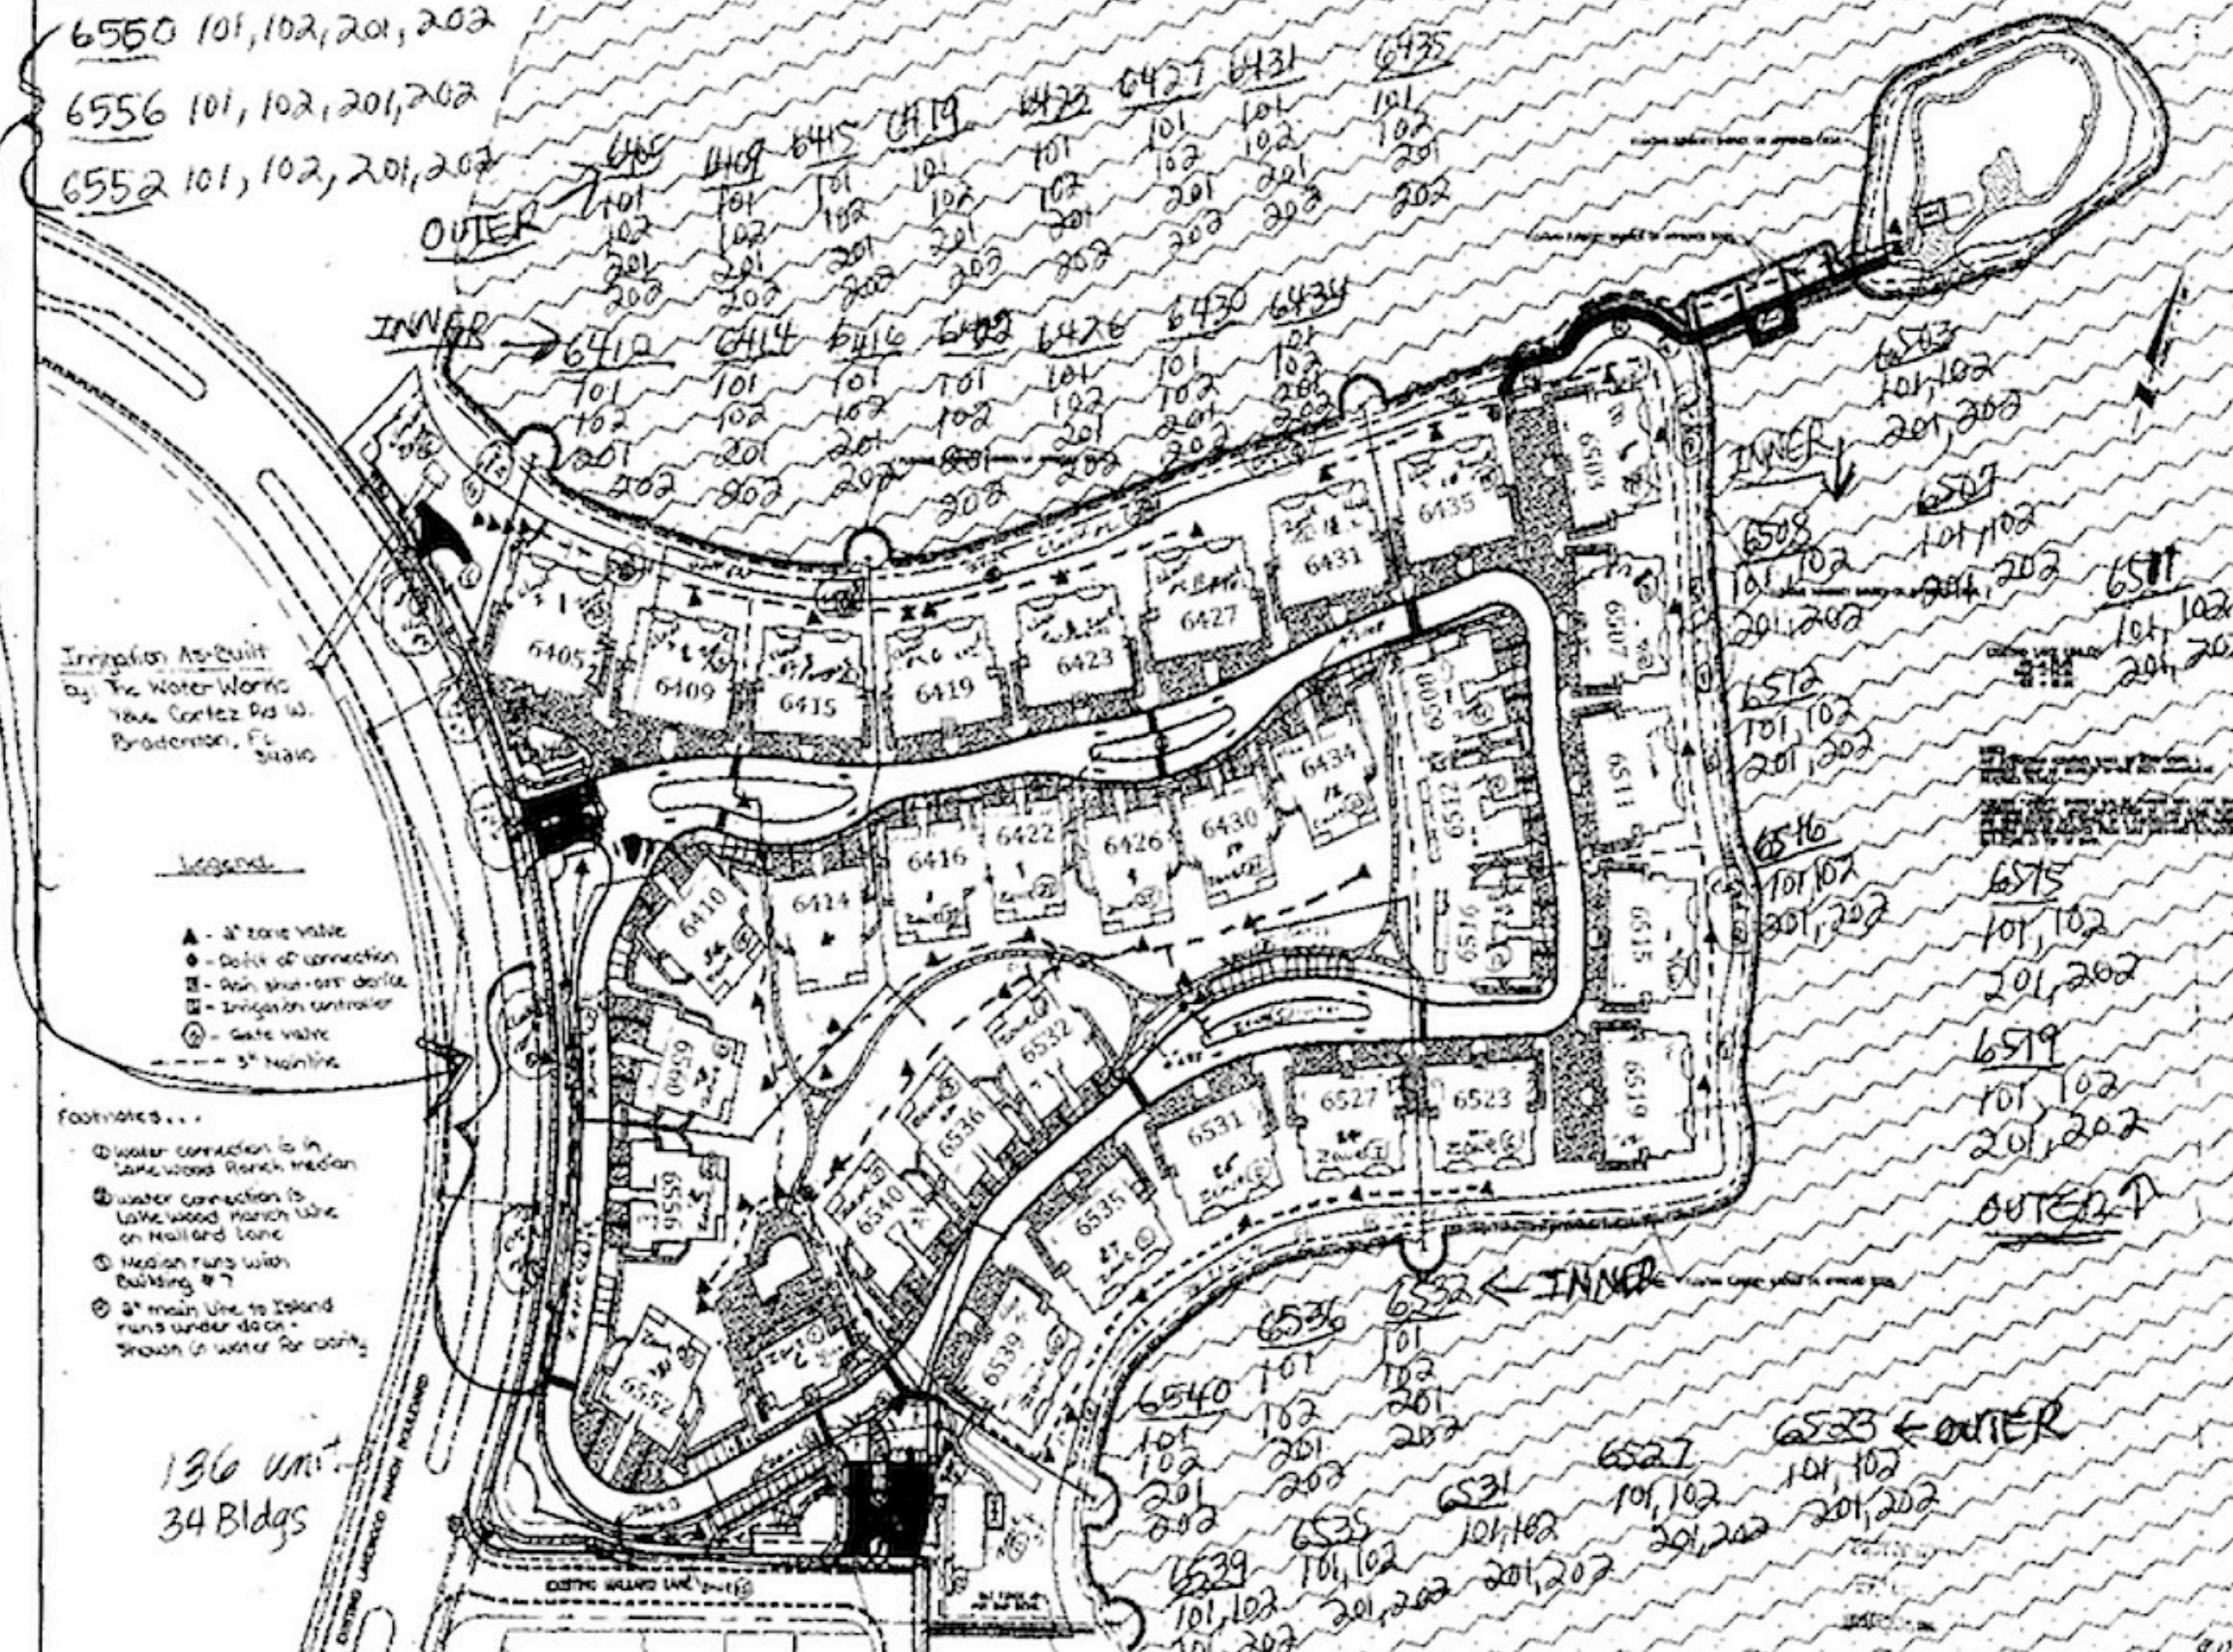

OUTER

INNER

OUTER